


Street Resurfacing Project

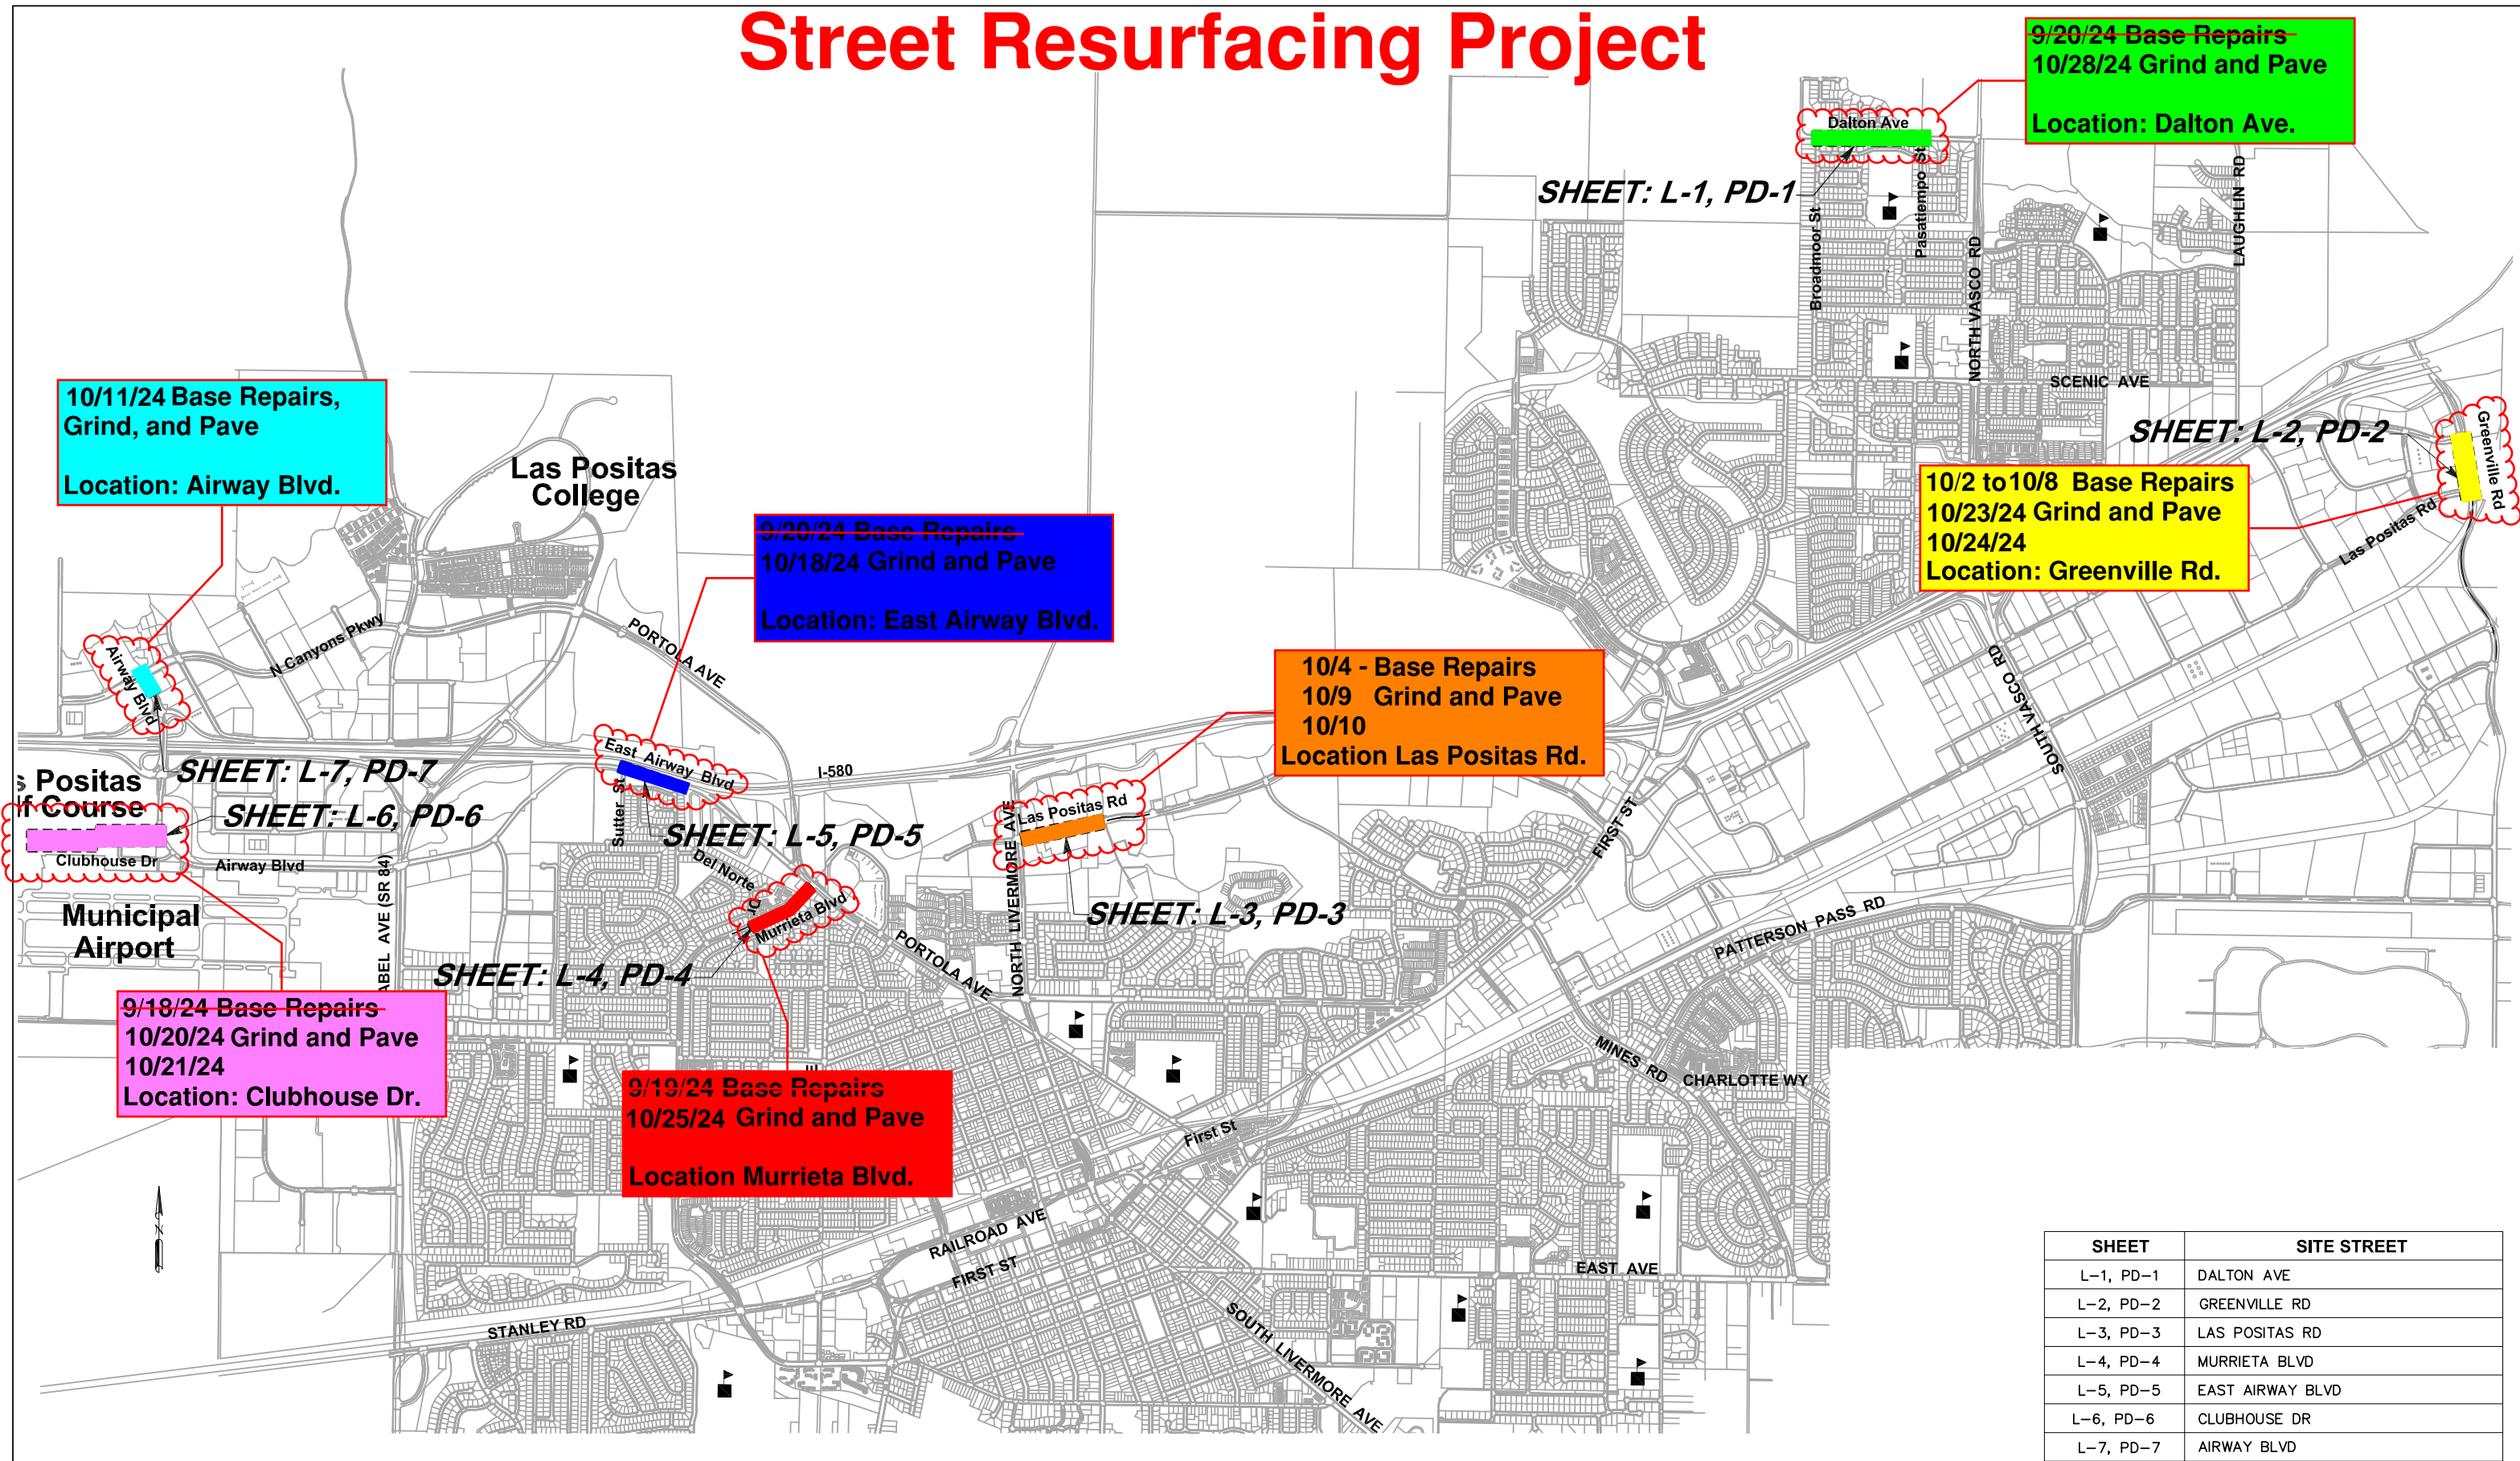

~~9/20/24 Base Repairs~~
~~10/28/24 Grind and Pave~~
Location: Dalton Ave.

~~10/11/24 Base Repairs,~~
~~Grind, and Pave~~
Location: Airway Blvd.

~~9/20/24 Base Repairs~~
~~10/18/24 Grind and Pave~~
Location: East Airway Blvd.

~~10/2 to 10/8 Base Repairs~~
~~10/23/24 Grind and Pave~~
~~10/24/24~~
Location: Greenville Rd.

~~10/4 - Base Repairs~~
~~10/9 Grind and Pave~~
~~10/10~~
Location Las Positas Rd.

~~9/18/24 Base Repairs~~
~~10/20/24 Grind and Pave~~
~~10/21/24~~
Location: Clubhouse Dr.

~~9/19/24 Base Repairs~~
~~10/25/24 Grind and Pave~~
Location Murrieta Blvd.

SHEET	SITE STREET
L-1, PD-1	DALTON AVE
L-2, PD-2	GREENVILLE RD
L-3, PD-3	LAS POSITAS RD
L-4, PD-4	MURRIETA BLVD
L-5, PD-5	EAST AIRWAY BLVD
L-6, PD-6	CLUBHOUSE DR
L-7, PD-7	AIRWAY BLVD

Inch
 1
 0

Roberto Escobar 4/5/24
 APPROVED BY DATE

DESIGNED BY: JT/RE
 DRAWN BY: JT/RE
 CHECKED BY: RE

NO. DATE BY REVISIONS

CITY OF
LIVERMORE
 CALIFORNIA
 COMMUNITY DEVELOPMENT DEPARTMENT - ENGINEERING DIVISION
 City Project No. 2022-01

2022 STREET RESURFACING

KEY MAP

K-1
 Sheet 2
 Of 22
 Scale: NTS